

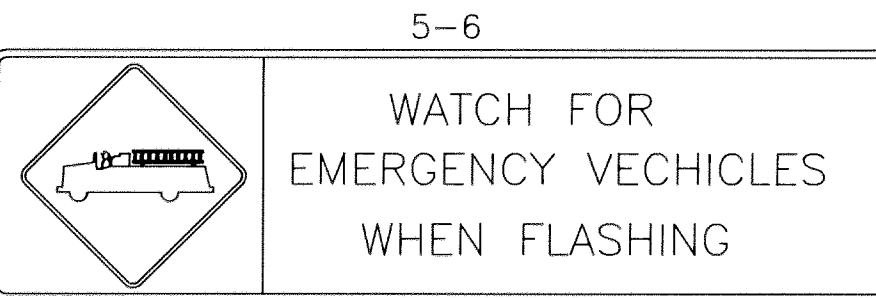


F H W A	STATE	FED. AID PROJ. NO.	SHEET NO.	TOTAL SHEETS
3	MD			

NEMA PHASING

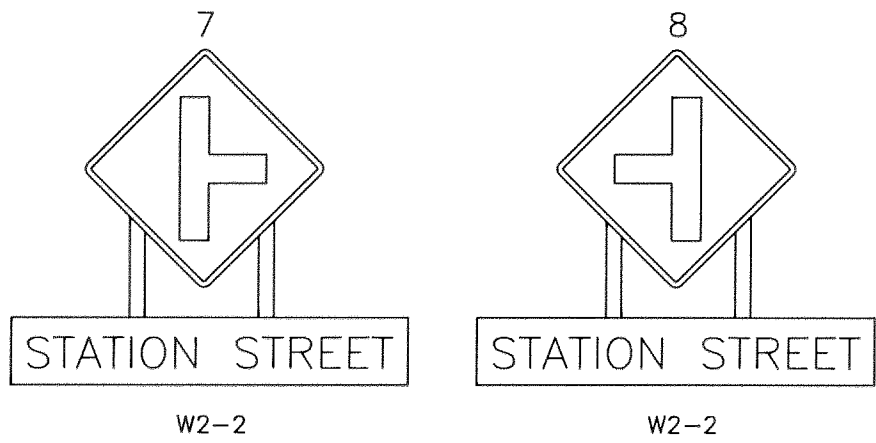


EXISTING SIGNALS

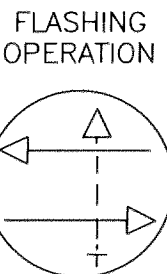

EXISTING SIGNS

NOTE:  
U.S. 50 IS ASSUMED  
TO RUN IN A EAST-WEST  
DIRECTION.

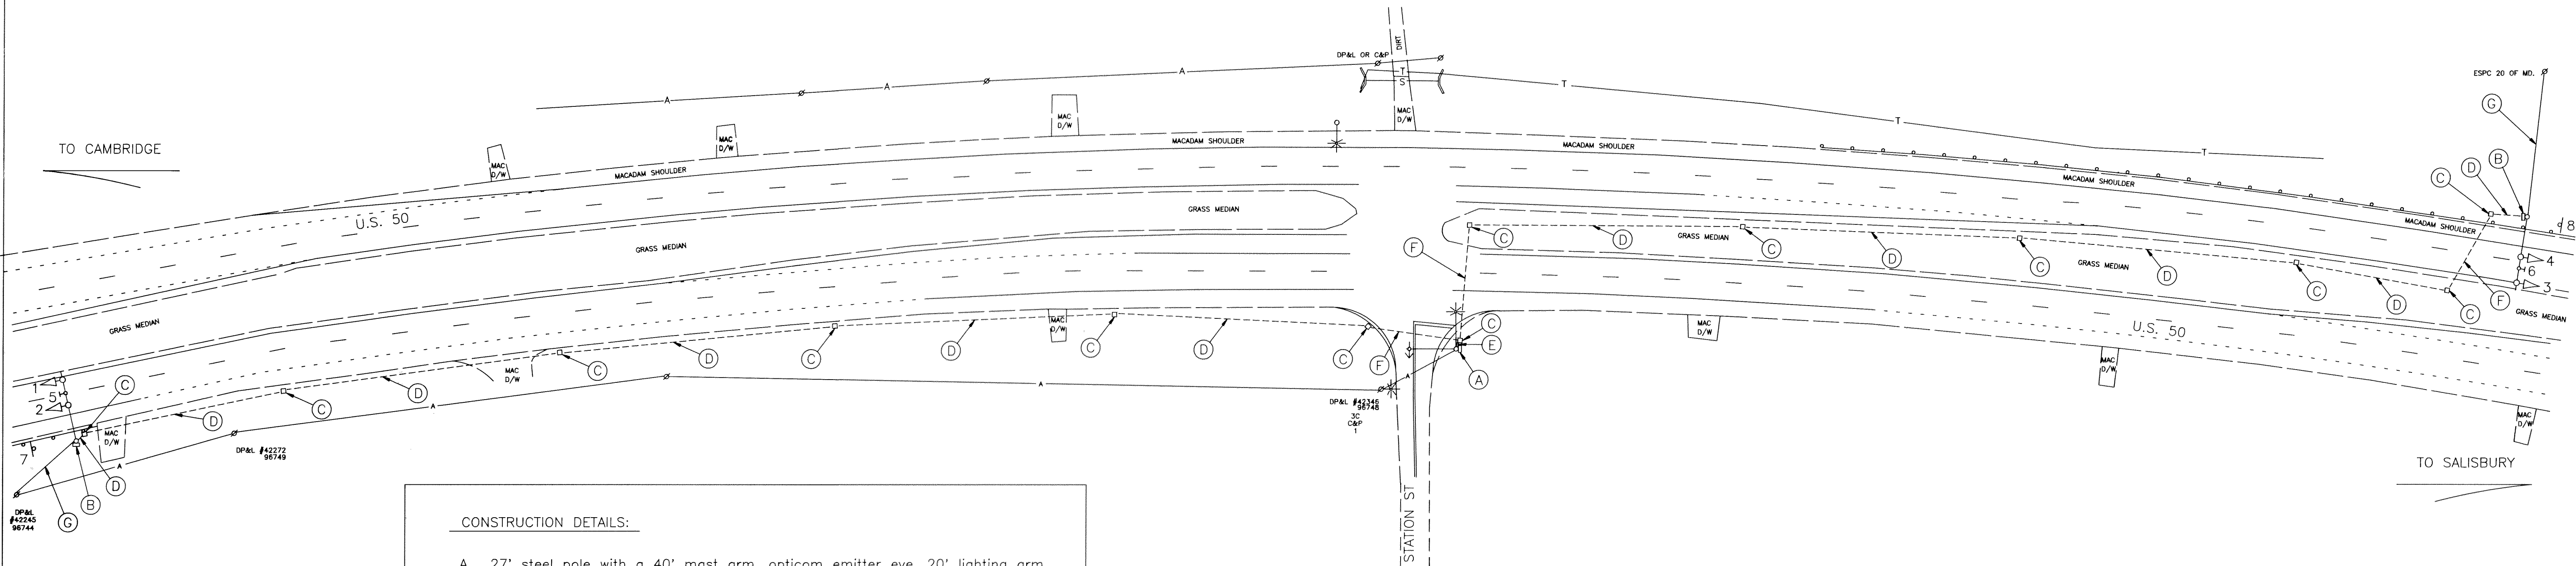

#### CONSTRUCTION DETAILS:

- 27' steel pole with a 40' mast arm, opticom emitter eye, 20' lighting arm and luminare, pole mounted cabinet, and photocell. (Note: 1-2", 90 degree polyvinyl chloride (Schedule 80) bend and 2-3", 90 degree polyvinyl chloride (Schedule 80) bends.)
- 21' steel pole with a 45' mast arm, traffic signals, photocell, and pole-mounted 15 amp dimmable flasher. (Note: 1-2" polyvinyl chloride (Schedule 80) bend.)
- Handhole
- 2" polyvinyl chloride conduit (Schedule 40) (trenched).
- 3" polyvinyl chloride conduit (Schedule 40) (trenched).
- 2" polyvinyl chloride conduit (Schedule 80) (bored).
- Overhead electrical service by DP&L.

#### GENERAL NOTES:



- This plan reflects only those underground utilities that were apparent at the time of this location being asbuilt. A detailed review was not undertaken and this plan should not be construed as representing all underground utilities in the area.
- Any modification to this subject signal should be preceded by a thorough identification of all existing utilities.

#### GEOMETRIC LEGEND

PROPOSED \_\_\_\_\_  
EXISTING \_\_\_\_\_

#### LEGEND OF UNDERGROUND AND OVERHEAD UTILITIES

AERIAL CABLE — A — A —  
ELECTRIC — E — E —  
TELEPHONE — T — T —  
GAS — G — G —  
SEWER — S — S —  
WATER — W — W —  
CABLE TV — TV — TV —

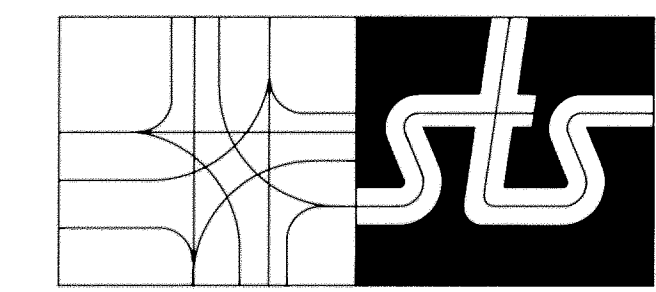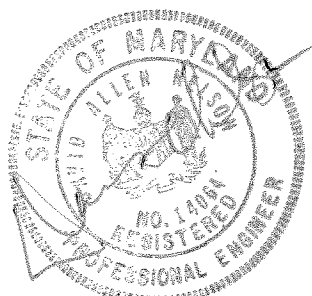

**STREET TRAFFIC STUDIES, LTD.**  
Gateway International  
1302 Concourse Drive, Suite 104  
Linthicum, Maryland 21090  
(410) 859-3553

2874

#### REVISIONS

NO.	DESCRIPTION	DATE
1	AS BUILT	10-6-95
2	SHA NO. :	
3	RRZ	

#### APPROVALS

CHIEF, SIGNAL DESIGN SECTION
ASST. DISTRICT ENGINEER, TRAFFIC
CHIEF, TRAFFIC ENGINEERING DESIGN DIVISION
DIRECTOR, OFFICE OF TRAFFIC AND SAFETY

MDOT — STATE HIGHWAY ADMINISTRATION  
Office of Traffic and Safety  
TRAFFIC ENGINEERING DESIGN DIVISION

SIGNAL NUMBER: 220050004.14

DRAWN BY: G SIMMERS / W MALCOLM

DES. BY:

CHK. BY:

DATE: 5-95

SCALE: 1"=50'

F.A.P. NO.

S.H.A. NO.

LOG MILE:

U.S. 50 AND STATION STREET

COUNTY WICOMICO

TS/STD. NO.

3511A

SHEET NO.

OF

22005004.14